

LOGANVIEW ROAD NORTH

LEGEND

- (FH) FIRE HYDRANT
- ⊗ (VS) STOP VALVE
- (TB) TAPPING BAND
- ⊗ (WM) WATER METER (SEQ 20Ø)
- └ END CAP
- ├ TEE
- BEND
- DI CL WATER MAIN CROSSING
- ==== CONDUIT/CROSSING
- EXISTING WATER

NOTES

- ALL WATER MAIN PIPES ARE PVC-M PN16 U.N.O.
- ALL WATER MAIN CROSSING PIPES ARE DI CL PN35 U.N.O.
- ALL FIRE HYDRANTS ARE Ø100 SPRING U.N.O.
- ALL SERVICE CROSSING CONDUITS ARE Ø100 uPVC PN9 U.N.O.

Works As Constructed



It is certified that the locations, Levels and dimensions of the infrastructure shown herein are a true representation of the constructed works and that the As-Constructed survey was performed to the prescribed accuracy standards.

Authorised Delegate.....*[Signature]*.....(Director)
 Date.....4/08/2023.....
 LandPartners Pty Ltd (ACN 118 146 008) Surveyor No. S4118

Works As Constructed

It is certified that works herein have been constructed to Local Government standards, relevant approved specifications and the operational works approval. The As-Constructed Drawings for these works constitutes a true and correct record of the works constructed and complies with the design intent.

Signature.....*[Signature]*.....RPEQ No.....
 Date of Practical Completion.....
 Engineering Consultant.....

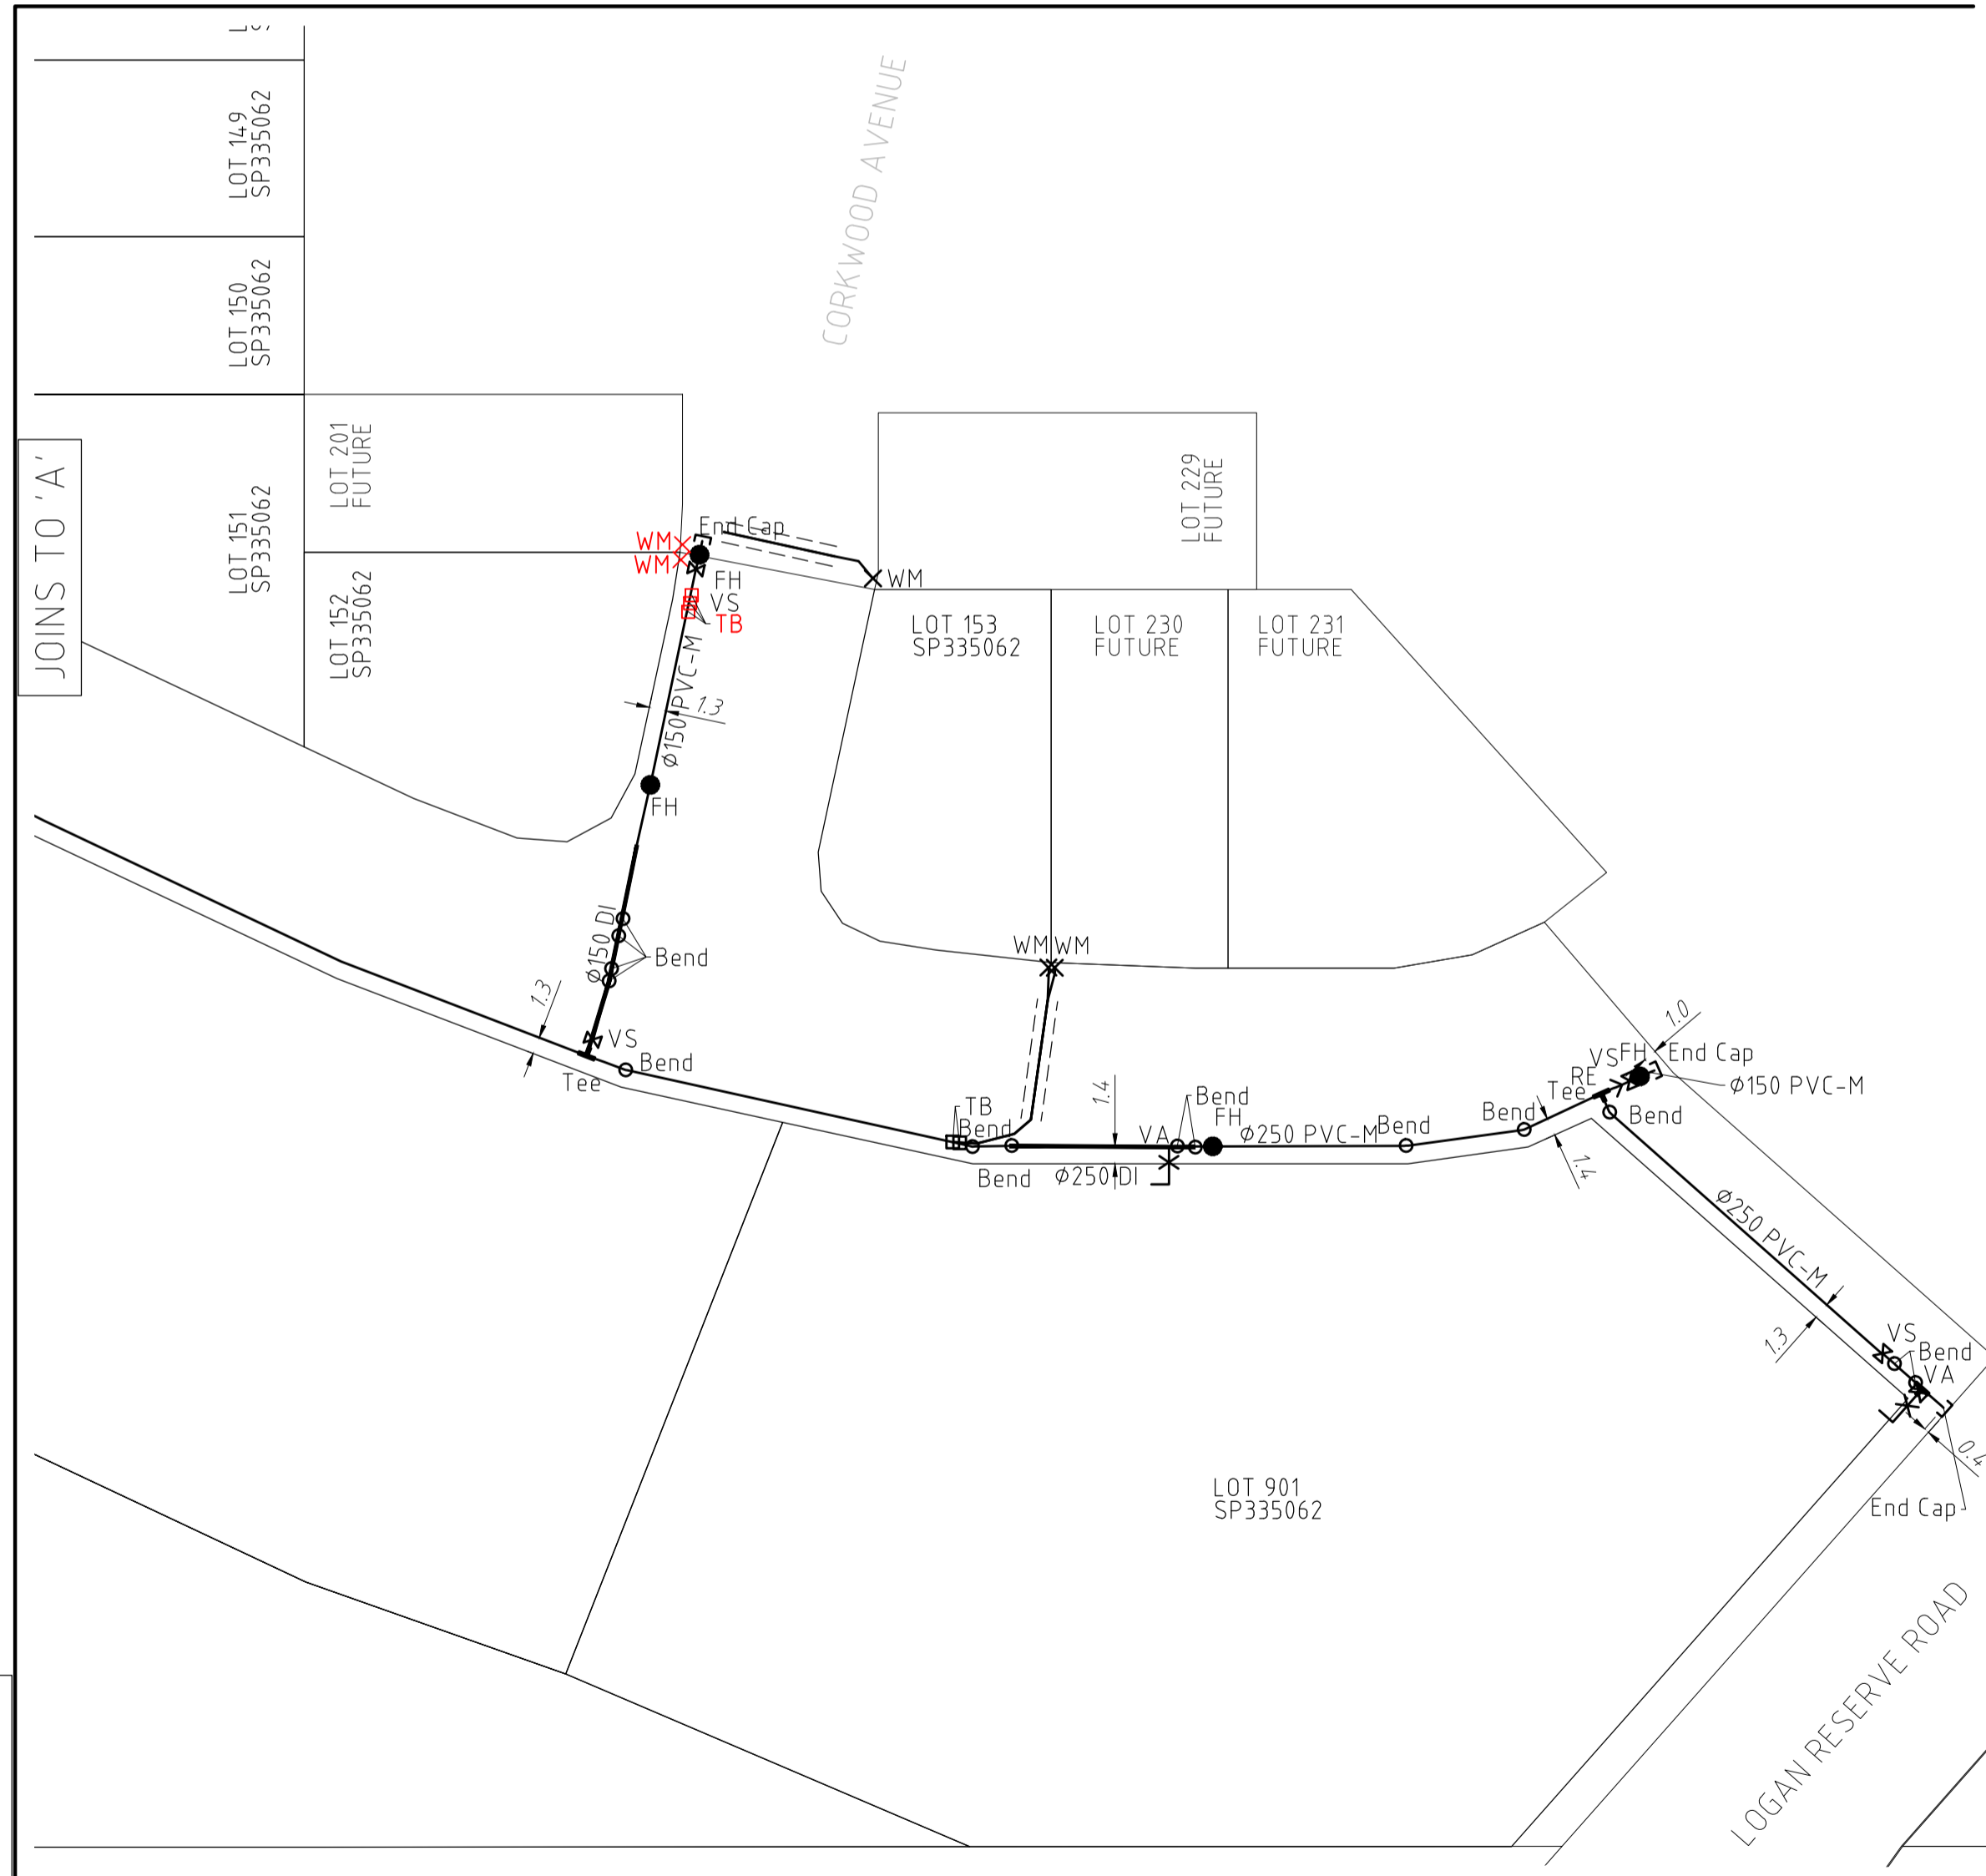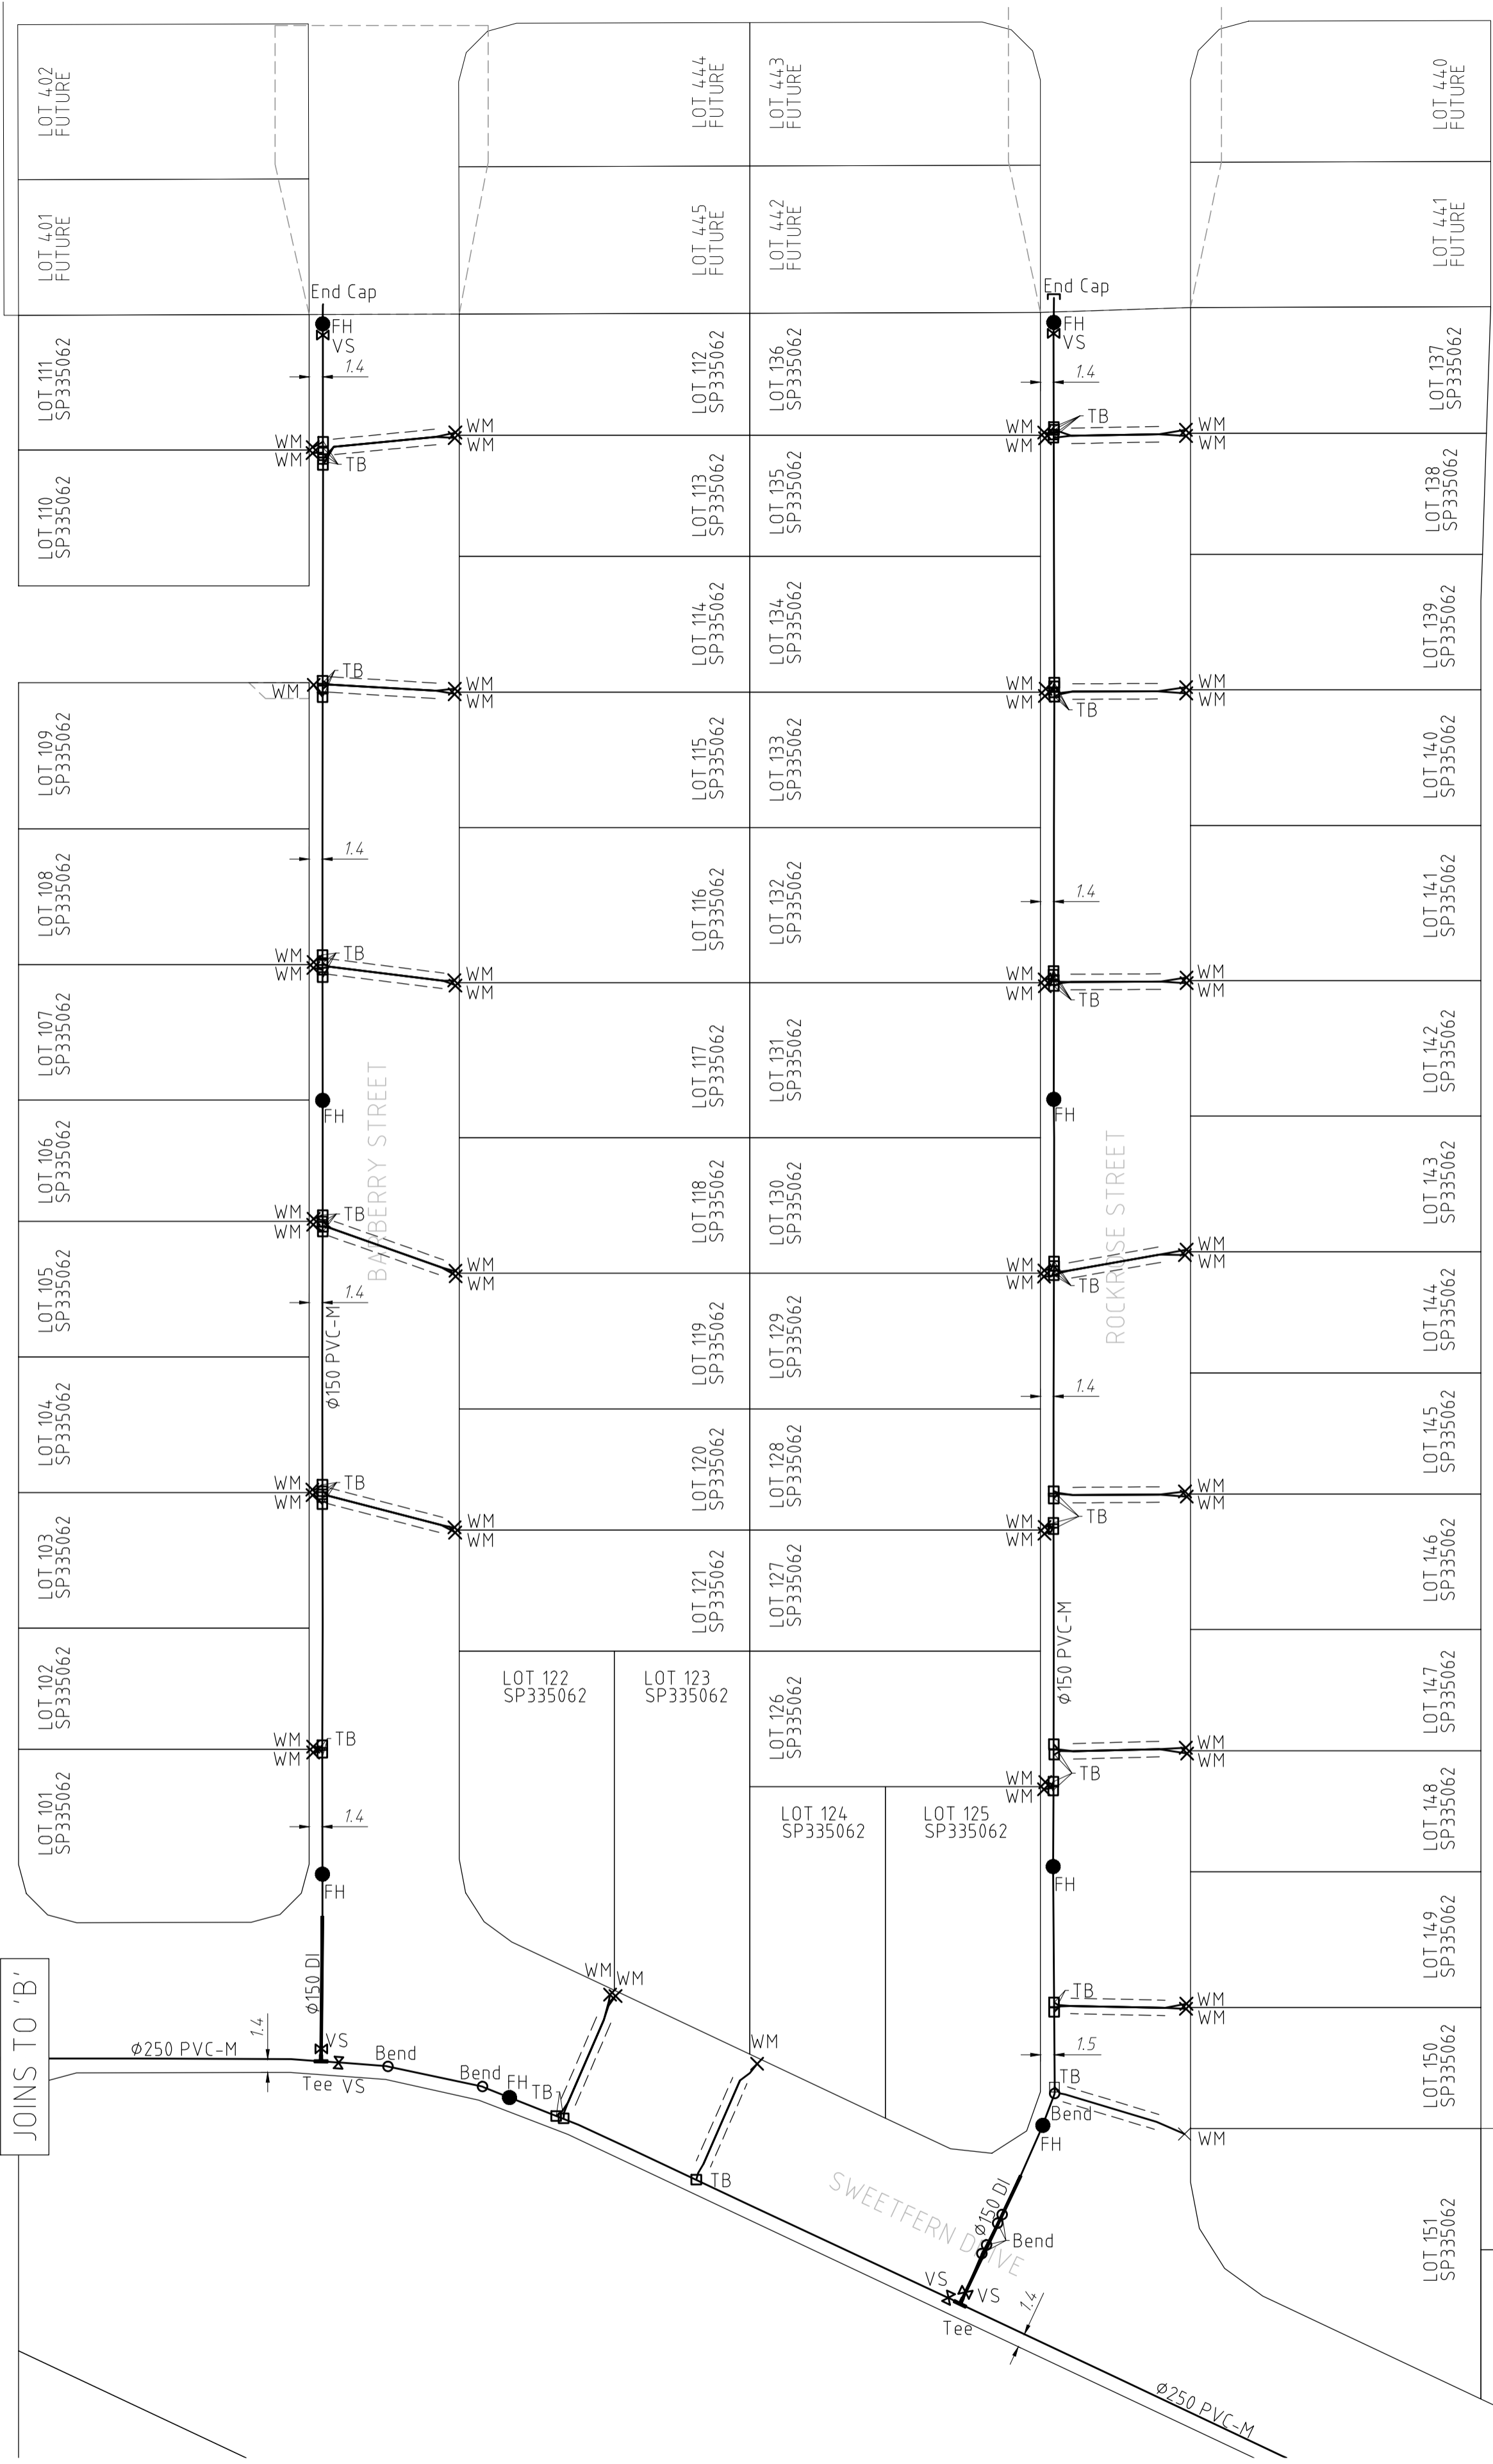

A1

ISSUE	DATE	AUTHOR	COMMENTS
1	4/08/2023	MJK	INITIAL ISSUE



CLIENT
ORCHARD (LOGANVIEW) DEVELOPMENTS PTY LTD

PROJECT
**WILLOW STAGE 1
AS CONSTRUCTED WATER
OW/106/2022**

ENGINEERING CONSULTANT
PEAK URBAN

LGA/SERVICE PROVIDER
LOGAN CITY COUNCIL

SCALE 1:500

SHEET 1 of 1		
DATUM	AHD	LEVEL ORIGIN
CONTOURS	N/A	FILE NO BRSS7540-00A-237-1
DRAWN	MJK	DATE 4/08/2023
CHECKED	VO	DATE 4/08/2023
APPROVED	RM	DATE 4/08/2023
PLAN NUMBER BRSS7540-00A-238-1		