



LOGANVIEW ROAD NORTH

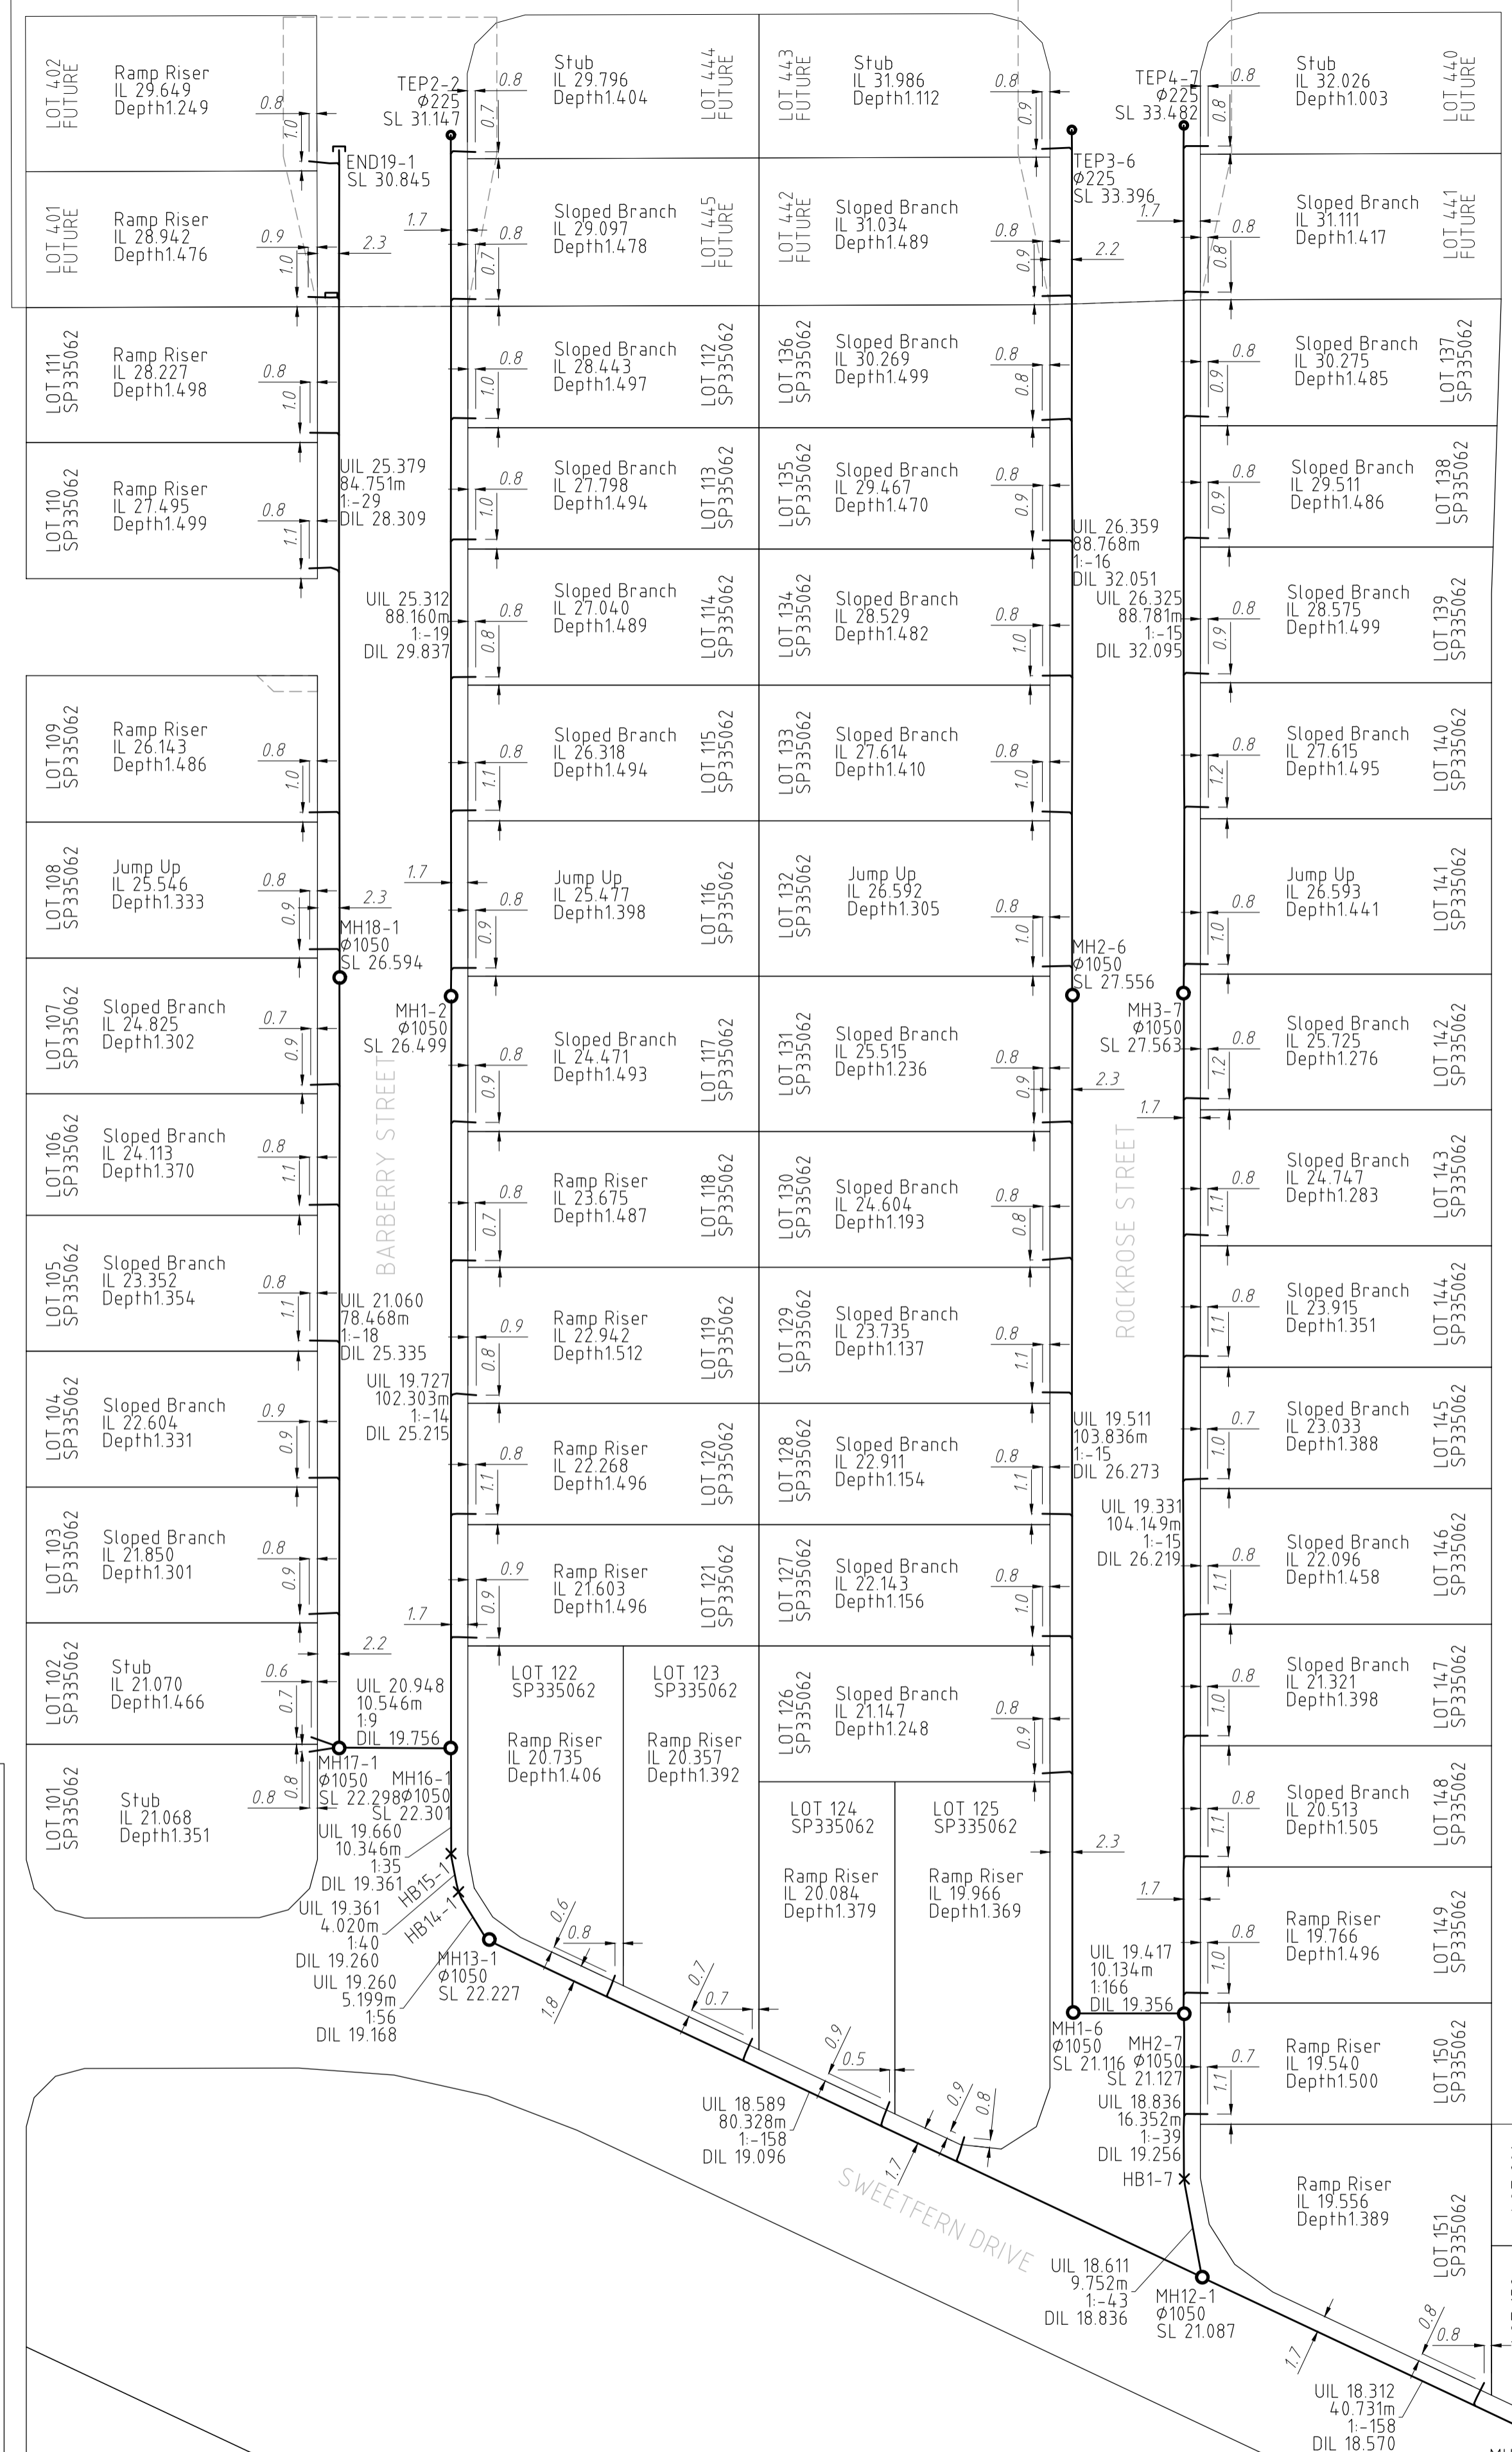

NOTES
 - ALL SEWER MAIN PIPES ARE CLASS 'SN8' Ø150 O.N.O
 - ALL HOUSE CONNECTIONS ARE CLASS 'SN6' Ø100 O.N.O

Works As Constructed
 It is certified that the locations, Levels and dimensions of the infrastructure shown herein are a true representation of the constructed works and that the As-Constructed survey was performed to the prescribed accuracy standards.
 Authorised Delegate... *C. Walters*
 Date... 8/08/2023
 LandPartners Pty Ltd (ACN 118 146 008) Surveyor No. S4118

Works As Constructed
 It is certified that works herein have been constructed to Local Government standards, relevant approved specifications and the operational works approval. The As-Constructed Drawings for these works constitutes a true and correct record of the works constructed and complies with the design intent.
 Signature.....RPEQ No.....
 Date of Practical Completion.....
 Engineering Consultant.....

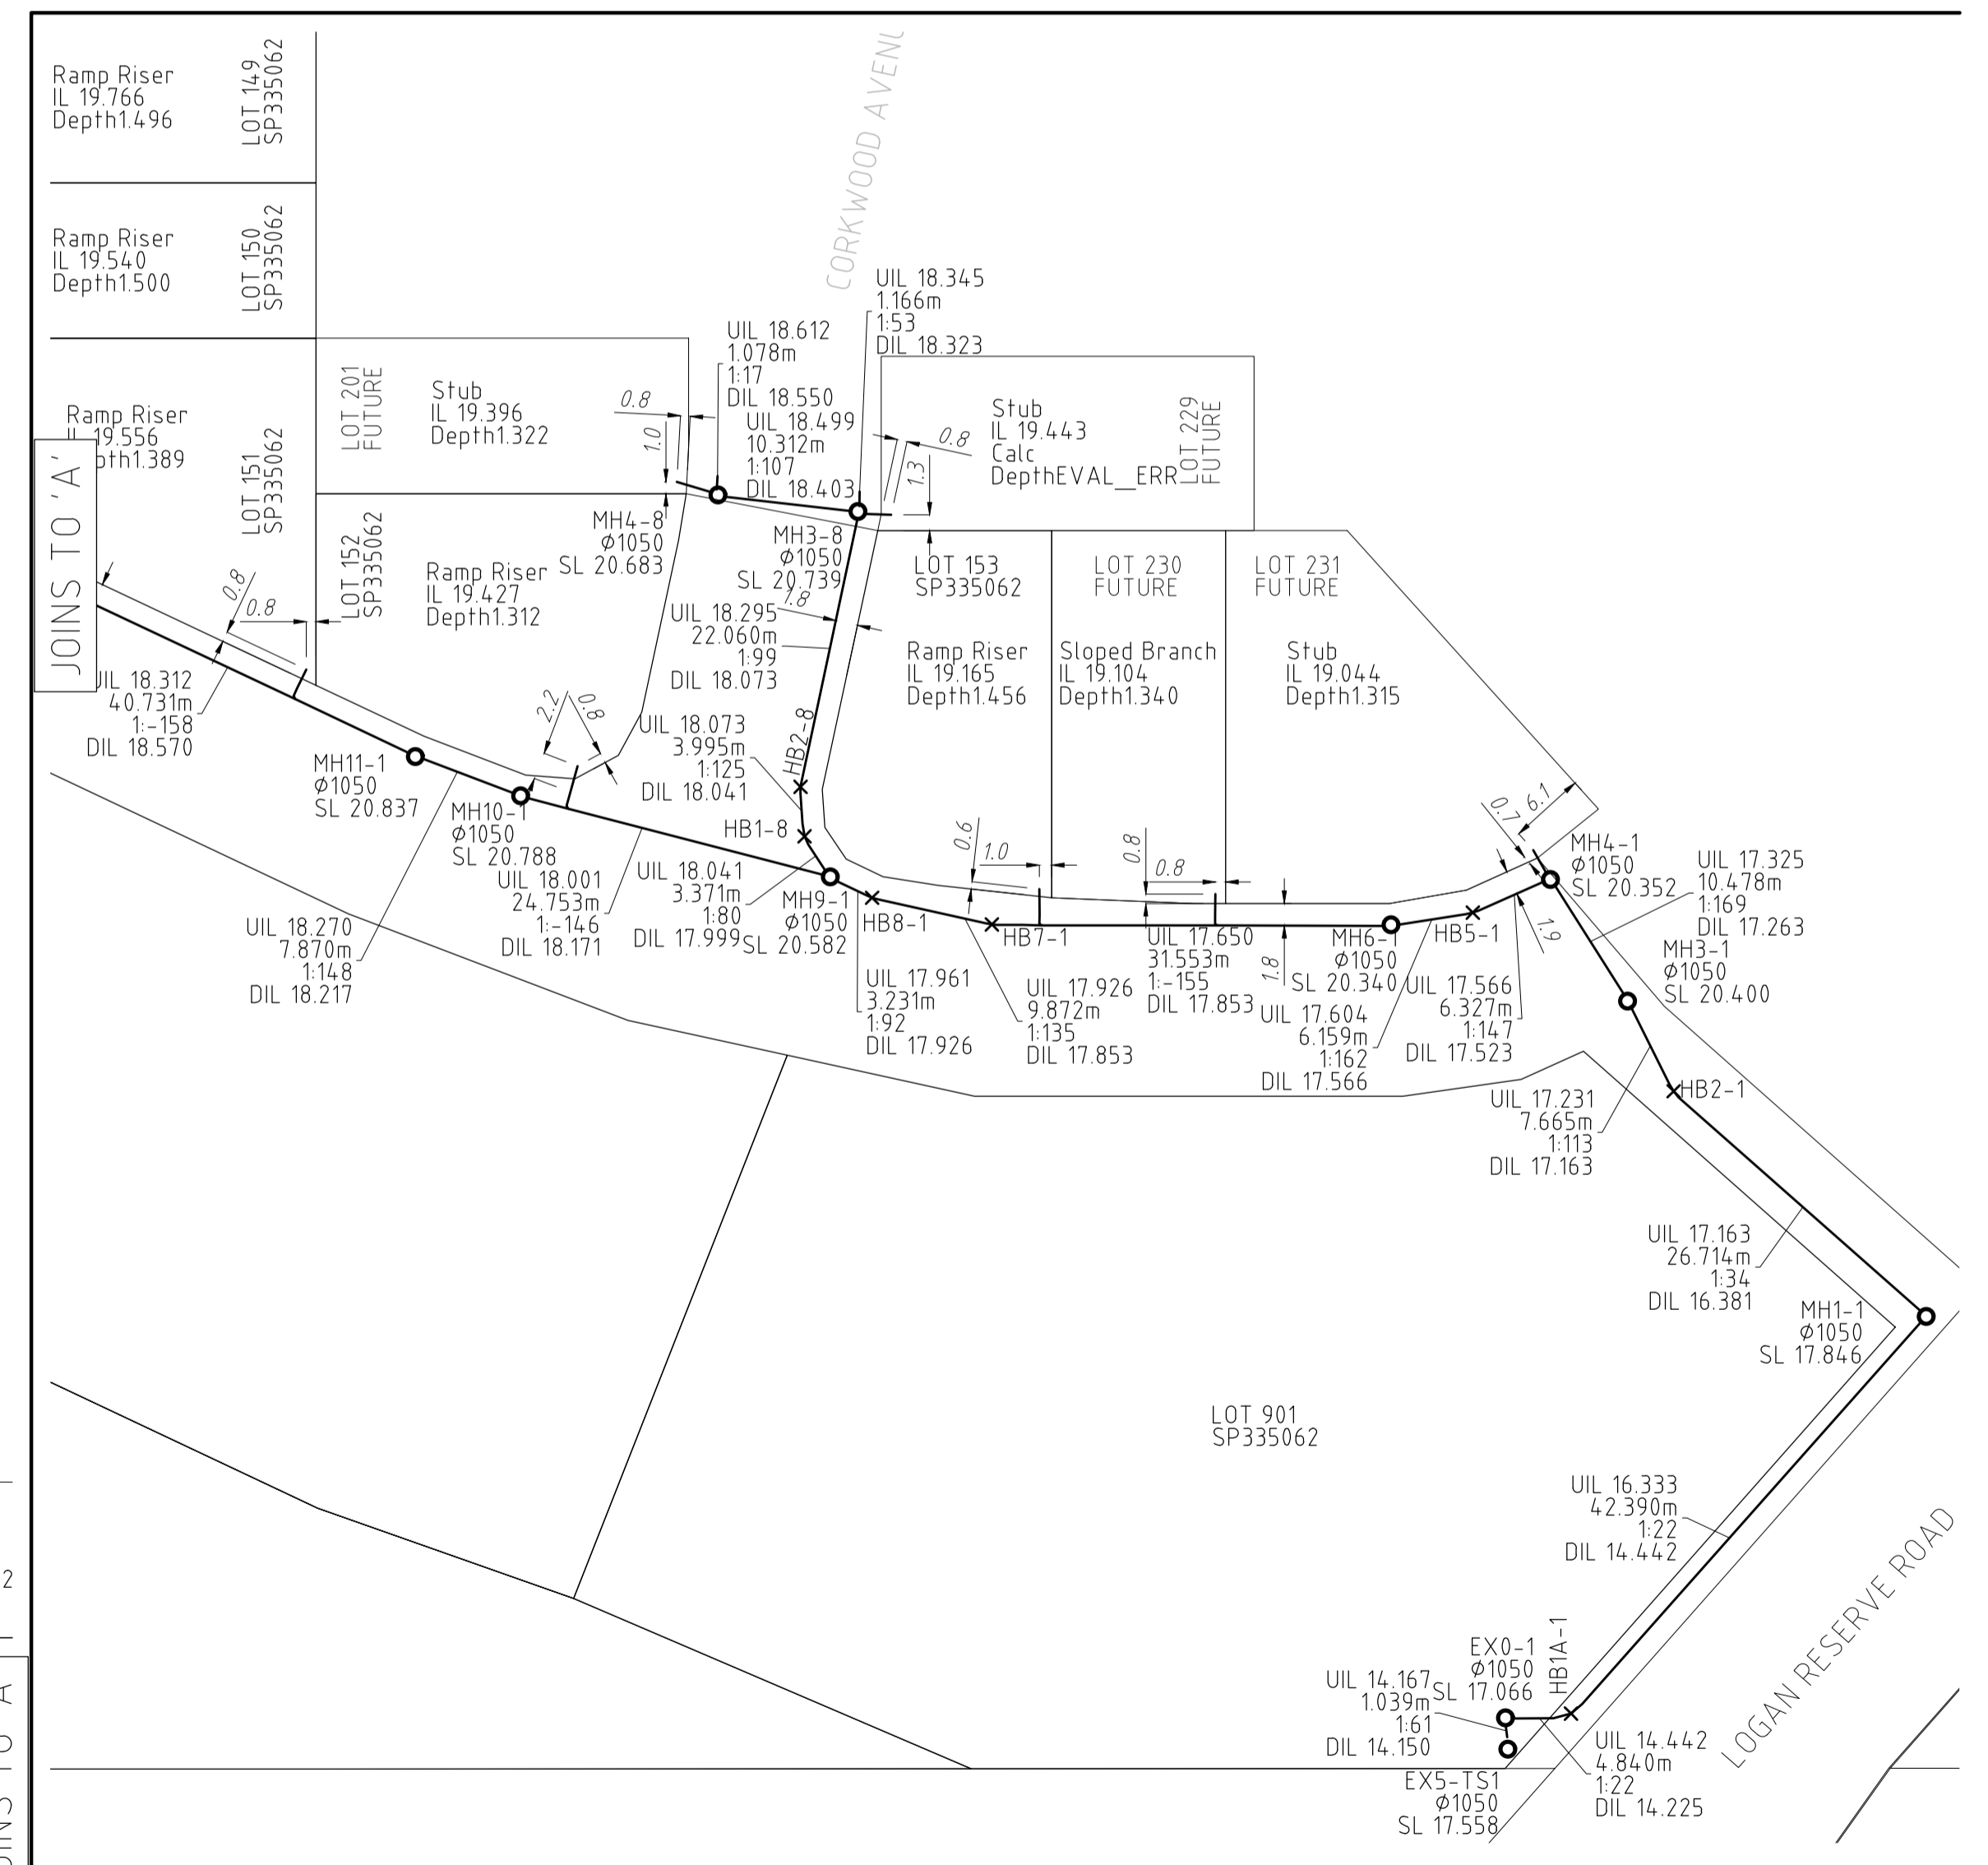

A1

ISSUE	DATE	AUTHOR	COMMENTS
1	8/08/2023	MJK	INITIAL ISSUE



CLIENT
ORCHARD (LOGANVIEW) DEVELOPMENTS PTY LTD

PROJECT
**WILLOW STAGE 1
 AS CONSTRUCTED SEWER
 OW/106/2022**

ENGINEERING CONSULTANT
PEAK URBAN

LGA/SERVICE PROVIDER
LOGAN CITY COUNCIL

SCALE 1:500

SHEET 1 of 1		
DATUM	AHD	LEVEL ORIGIN
CONTOURS	N/A	FILE NO BRSS7540-00A-237-2
DRAWN	MJK	DATE 8/08/2023
CHECKED	VO	DATE 8/08/2023
APPROVED	CGW	DATE 8/08/2023
PLAN NUMBER BRSS7540-00A-240-1		