


A1	ISSUE	DATE	AUTHOR	COMMENTS	ISSUE	DATE	AUTHOR	COMMENTS
	1	29/11/2023	VO	INITIAL ISSUE				


											SP07 33755 697
									4.00	84 84 14 55	hr.
SF	OT 248 L 2337691 S	.0T 249 L P337691 S	_OT 250 P337691	LOT 251 SP337691	LOT 252 SP337691	.0T 253 SP337691	10151 10151	1000 1000		ТВ	
	WM WM		WM WM	7:1	WM W FH	M TB	ТВ	000	Bend TB		WANNA WAY
DRN STF		W	1WM	WM	WM	Х	/// Ben /// WM		WMWM	5,07 5,07 3,37 5,34 6,97	
					****					2	(07 335 697 50 50 50 50 50 50 50 50 50 50
)T 244 337691	LOT 243 SP337691 LOT 219	LOT 242 SP337691 LOT 220	LOT 241 SP337691 LOT 221	LOT 240 SP337691 LOT 222	LOT 239 SP337691 LOT 223	LOT 238 SP337691	LOT 237 SP337691 LOT 225	LOT 236 SP337691 LOT 226	LOT SP3	- 235 37691 LOT 228	LOT 229
OT 218 2337691	SP337691	SP337691	SP337691	SP337691	SP337691	LOT 224 SP337691	SP337691	SP337691	SP337691	SP337691	LOT 229 SP337691
-В	+; ;/	TB F	тн •	WM WM		TB		TB TB WWM			
LOT 212 5P337691	LOT 211 SP337691	LOT 210 SP337691	LOT 209 SP337691	LOT 208 SP337691	LOT 207 SP337691	LOT 206 SP337691	LOT 205 SP337691	LOT 204 SP337691	LOT 203 SP337691	LOT 202 SP337691	LOT 201 SP337691



Brisbane Office Level 1 18 Little Cribb Street Milton QLD 4064 PO Box 1399 Milton QLD 4064 p: (07) 3842 1000 f: (07) 3842 1001 e: info@landpartners.com.au w: www.landpartners.com.au CLIENT ORCHARD (LOGANVIEW) DEVELOPMENTS PTY LTD

> WILLOW STAGE 2 AS CONSTRUCTED WATER OW/214/2022

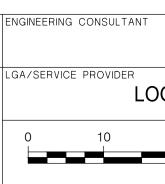

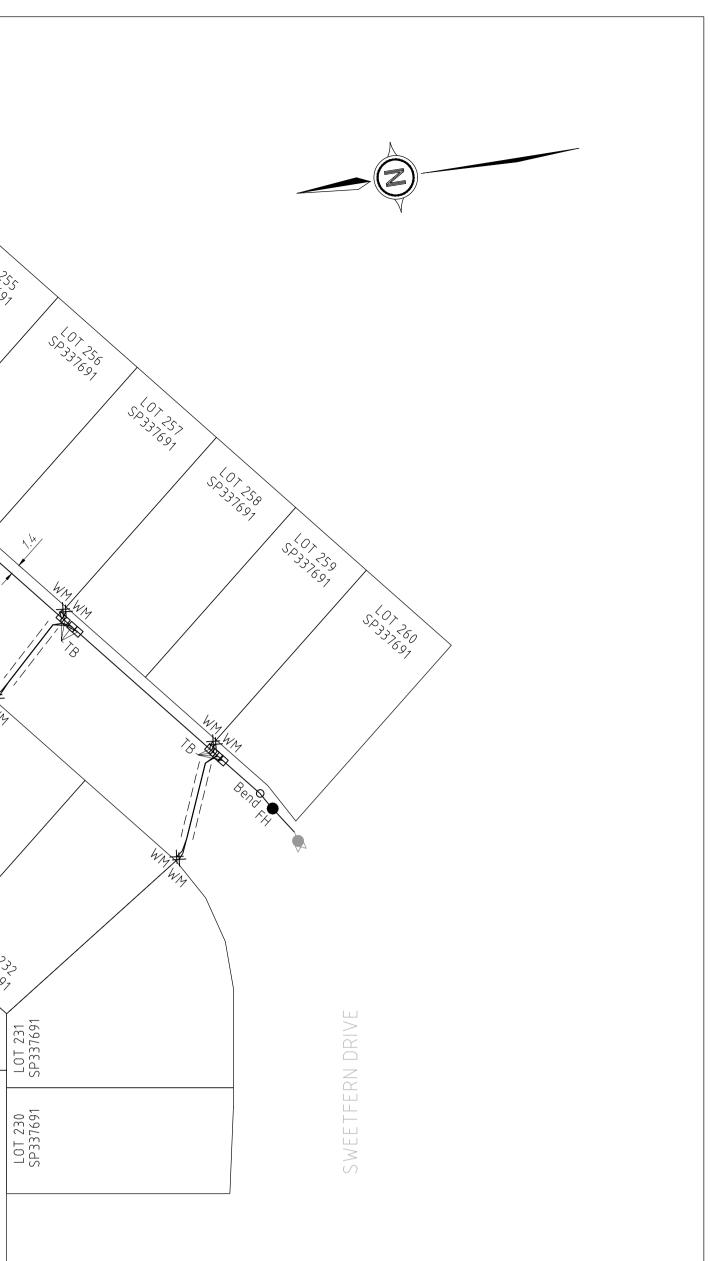

		SHEET 1 of 1					
COLLIERS		DATUM	AHD	LEVEL ORI	GIN _		
COLLIERS		CONTOURS	N/A	FILE NO.	BRSS7540-00A-362-1		
OGAN CITY COUNCIL		DRAWN	VO	DATE	29/11/2023		
JGAN CITY COUNCIL		CHECKED	CW	DATE	29/11/2023		
25	55m	APPROVED	CW	DATE	29/11/2023		
		PLAN NUMBER					
SCALE 1:500		BRSS7540-00A-365-1					

©LandPartners 2023