

**Works As Constructed**

It is certified that the locations, Levels and dimensions of the infrastructure shown herein are a true representation of the constructed works and that the As-Constructed survey was performed to the prescribed accuracy standards.

Authorised Delegate.....*[Signature]*  
 Date..... 19/12/2023  
 LandPartners Pty Ltd (ACN 118 146 008) Surveyor No. S4118

**Works As Constructed**

It is certified that works herein have been constructed to Local Government standards, relevant approved specifications and the operational works approval. The As-Constructed Drawings for these works constitutes a true and correct record of the works constructed and complies with the design intent.

Signature.....RPEQ No.....  
 Date of Practical Completion.....  
 Engineering Consultant.....

**A1**

ISSUE	DATE	AUTHOR	COMMENTS
1	19/12/2023	VO	INITIAL ISSUE




Brisbane Office  
 Level 1  
 18 Little Cribb Street  
 Milton QLD 4064  
 PO Box 1399  
 Milton  
 QLD 4064  
 P: (07) 3842 1000  
 F: (07) 3842 1001  
 E: info@landpartners.com.au  
 www.landpartners.com.au

CLIENT  
**ORCHARD (LOGANVIEW) DEVELOPMENTS PTY LTD**

PROJECT  
**WILLOW STAGE 2  
 AS CONSTRUCTED STORMWATER  
 OW/214/2022**

ENGINEERING CONSULTANT  
**COLLIERS**

LGA/SERVICE PROVIDER  
**LOGAN CITY COUNCIL**

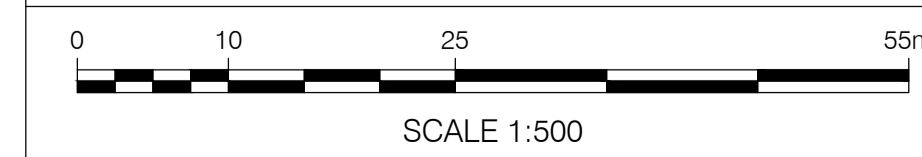

SHEET		
<b>1 of 1</b>		
DATUM	AHD	LEVEL ORIGIN
CONTOURS	N/A	FILE NO BRSS7540-00A-366-1
DRAWN	VO	DATE 19/12/2023
CHECKED	MK	DATE 19/12/2023
APPROVED	RM	DATE 19/12/2023
PLAN NUMBER	<b>BRSS7540-00A-367-1</b>	