



Consulting Engineer's Certification:

I, hereby certify that the As Constructed information shown on the plan is a true and correct record of the sizes, types, materials, classes etc., and it corresponds with the relevant approved Engineering Drawings.

Signed..... RPEQ No..... Dated.....

REGISTERED CADASTRAL SURVEYOR (QLD) CERTIFICATION:

LandPartners Pty Ltd, hereby certify that the horizontal and vertical locations, and dimensions shown on this plan are a true and correct record of the As Constructed information.

Signed *R. G. Anderson* Date 20/08/2024
(Authorised Delegate)

LandPartners Pty Ltd, Registered Cadastral Surveyor SBQ ID 4118

CLIENT

ORCHARD (LOGANVIEW) DEVELOPMENTS PTY LTD

PROJECT

AS CONSTRUCTED STORMWATER OF WILLOW STAGE 3 LOGAN RESERVE

NOTES

- ALL STORMWATER PIPES ARE RCP '3' U.N.O.

ENGINEERING FIRM:

COLLIERS INTERNATIONAL ENGINEERING & DESIGN PTY LTD

| REV | DATE | DRAWN | CHECKED | APPROVED | NOTE |
|-----|------------|-------|---------|----------|---------------|
| 1 | 20/08/2024 | MJK | RA | RA | INITIAL ISSUE |




Brisbane Office
Level 1
18 Little Cribb Street
Milton QLD 4064

PO Box 1399
Milton
QLD 4064

p: (07) 3842 1000
f: (07) 3842 1001
e: info@landpartners.com.au
w: www.landpartners.com.au

| | |
|--------------|------------------|
| LEVEL DATUM | LOCAL AUTHORITY |
| AHD | LOGAN C.C. |
| LEVEL ORIGIN | CONTOUR INTERVAL |
| - | - |
| MERIDIAN | CO-ORD SYSTEM |
| MGA94 | MGA ZONE 56 |

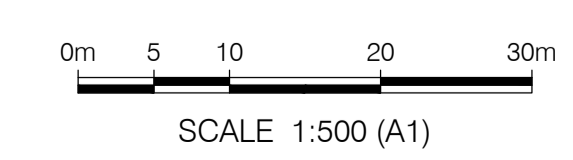

UDN SHEET 1 OF 1

BRSS7540-00A-466-1

©LANDPARTNERS 2024